

March 19, 2020

Fiberlight, LLC
Tim Green
6089 John's Road, Suite 7
Tampa, FL 33634

ADJUSTMENT OF UTILITIES-STATE STATUTE CHAPTER 337.403

Project Road: East Twiggs Street
County: Hillsborough
THEA Project ID: 0-00419
Description: East Twiggs Street from West of N. Nebraska Avenue to West of N. Meridian Avenue. – Design-Build Widening Project

Dear Mr. Green:

For the above referenced project, WGI is under contract with the Tampa Hillsborough Expressway Authority to coordinate relocations and/or adjustments of your facilities. Please address all correspondence concerning all coordination, both verbal and written, to WGI, Chris Stermer, Utility Coordination Manager. Please send all correspondence to the address below.

The enclosed Utility Work Schedule has been approved by Tampa-Hillsborough Expressway Authority (THEA). THEA anticipates letting the Design-Build Project in Fall 2020. THEA is requesting that all possible relocations for the project be completed prior to the Design Build Contracts award. Therefore, all UAO work for this project must be completed by **September 1, 2020**. You are advised to proceed with your utility work as depicted in the approved Utility Work Schedule (UWS).

Prior to the commencement of your work, you must obtain all required Utility Permits. To expedite your permit review time, please include your executed UWS with all permit applications.

Any changes, revisions, deletions, or additions to the approved Utility Work Schedule must be documented and approved by the THEA. Upon completion of construction, as-built plans must be provided to this office.

A Pre-Construction meeting has been scheduled for **3:00 PM on April 9, 2020** via WebEx. An Outlook meeting invite will be sent to include a WebEx link. If you are not able to call-in, please have a knowledgeable representative call-in in your absence.

Thank you for your cooperation. Should you have any questions don't hesitate to contact me directly at 813-559-2262, or by email at Chris.Stermer@WGInc.com.

Sincerely,
Chris Stermer
Utility Coordination Manager



Enclosures

cc: David May, PE, THEA Director of Expressway Operations
Judith Villegas, EI, THEA, Project Manager
James E. Drapp, PE, VP, HNTB, Project Manager
Alphonse Stewart, PE, HNTB, Project Manager
Megan Tetro, PE, WGI, EOR, Project Manager

File

TAMPA HILLSBOROUGH
EXPRESSWAY AUTHORITY

CONTRACT PLANS

INDEX OF ROADWAY PLANS	
SHEET NO.	SHEET DESCRIPTION
1	KEY SHEET
2	SIGNATURE SHEET
3	GENERAL NOTES
UTV-1	SUMMARY OF VERIFIED UTILITIES
4 - 5	UTILITY ADJUSTMENT TYPICAL SECTION* ROADWAY PLAN*

* PLAN SHEETS PROVIDED FOR INFORMATION ONLY





Fiberlight Markups 11-14-19

PROJECT ID: O-00419

HILLSBOROUGH COUNTY (10002)

E. TWIGGS STREET UTILITY ADJUSTMENTS

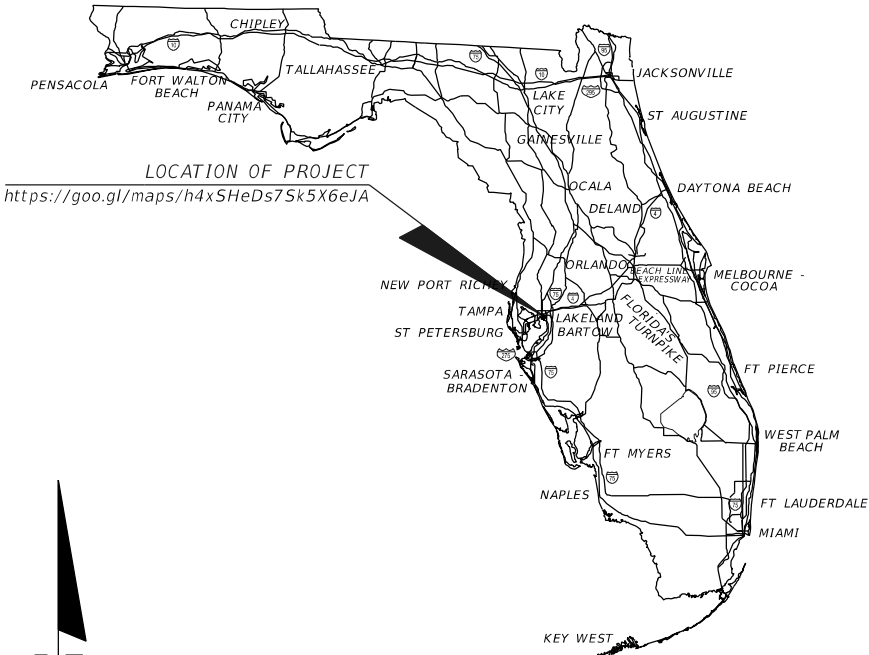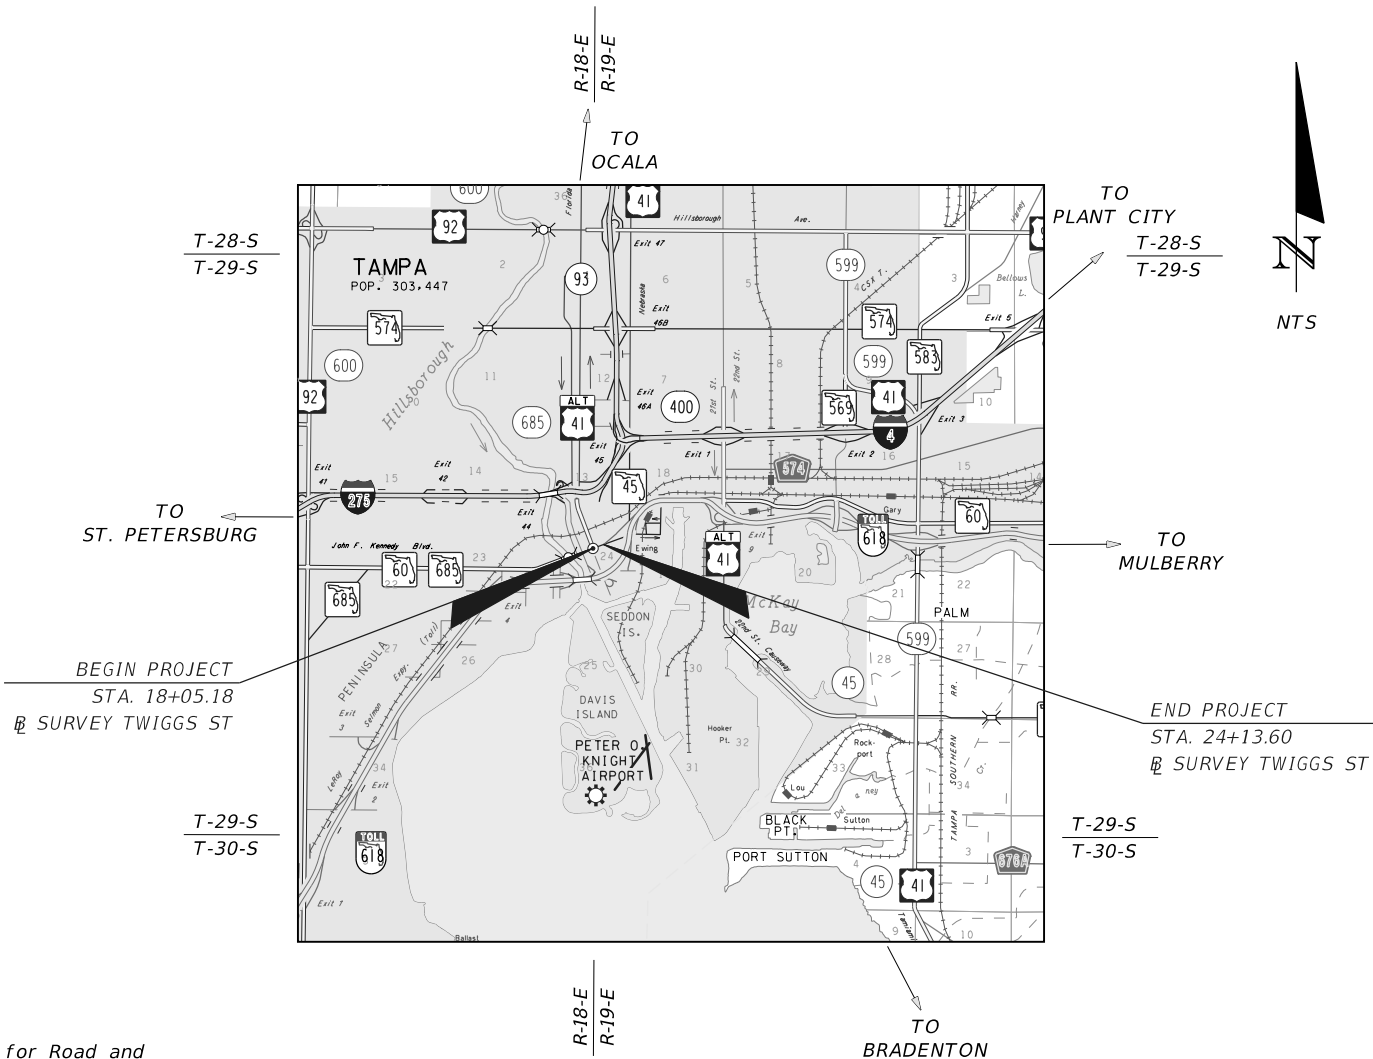

ROADWAY PLANS
ENGINEER OF RECORD:

MEGAN M. TETRO, P.E. NO.: 76120
WANTMAN GROUP, INC.
3111 W. DR. MARTIN LUTHER KING JR. BLVD.,
SUITE 375, TAMPA, FL 33607
(813) 574-3190
CERTIFICATE OF AUTHORIZATION NO.: 6091

THEA PROJECT MANAGER:

DAVID MAY, P.E.

GOVERNING STANDARD PLANS:


Florida Department of Transportation, FY2018/19 Standard Plans for Road and Bridge Construction and applicable Interim Revisions (IRs).

Standard Plans for Road Construction and associated IRs are available at the following website: <http://www.fdot.gov/design/standardplans>

GOVERNING STANDARD SPECIFICATIONS:


Florida Department of Transportation, July 2018 Standard Specifications for Road and Bridge Construction at the following website: <http://www.fdot.gov/programmanagement/Implemented/SpecBooks>

CONSTRUCTION CONTRACT NO.	FISCAL YEAR	SHEET NO.
		1

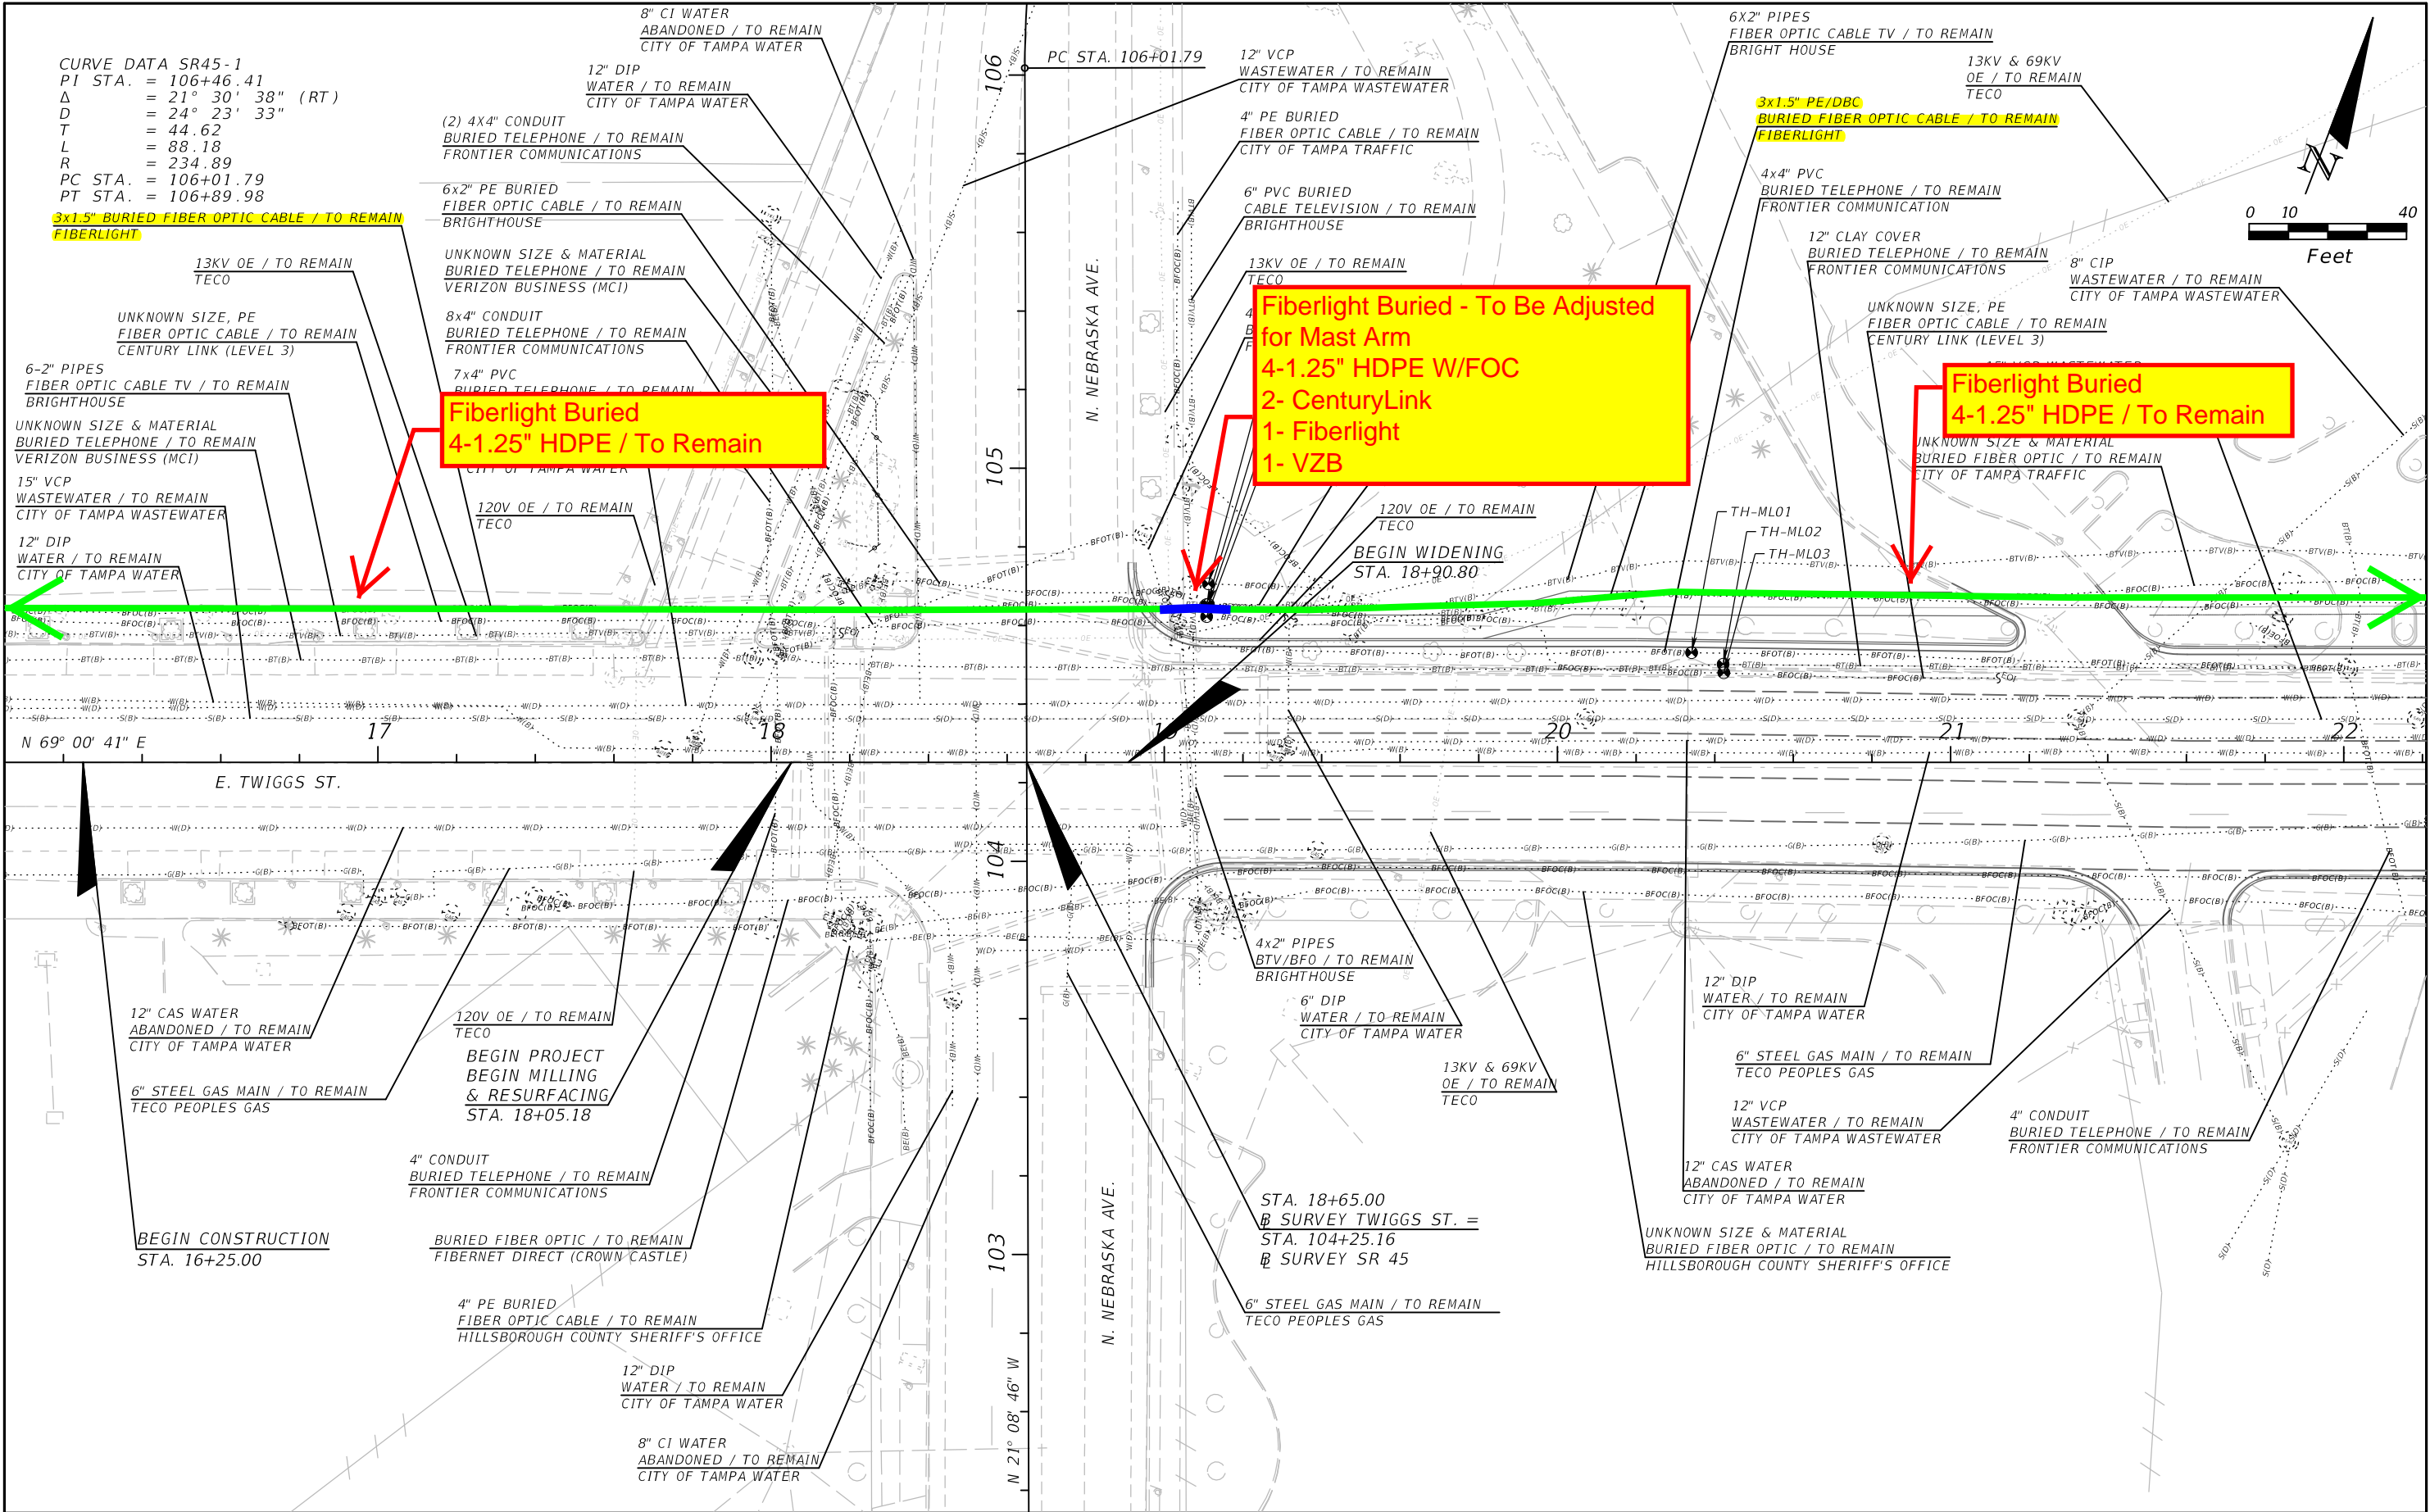

REVISIONS				MEGAN M. TETRO, P.E. FLORIDA PE NO. 76120 WANTMAN GROUP, INC. 3111 W. MARTIN LUTHER KING JR. BLVD., SUITE 375, TAMPA, FL 33607 CERTIFICATE OF AUTHORIZATION NO. 6091	TAMPA HILLSBOROUGH EXPRESSWAY AUTHORITY			UTILITY ADJUSTMENT (1)	SHEET NO. 4
DATE	DESCRIPTION	DATE	DESCRIPTION		ROAD	COUNTY	CONTRACT NO.		
					TWIGGS	HILLSBOROUGH	000419		

THE OFFICIAL RECORD OF THIS SHEET IS THE ELECTRONIC FILE DIGITALLY SIGNED AND SEALED UNDER RULE 61G15-23.004, F.A.C.

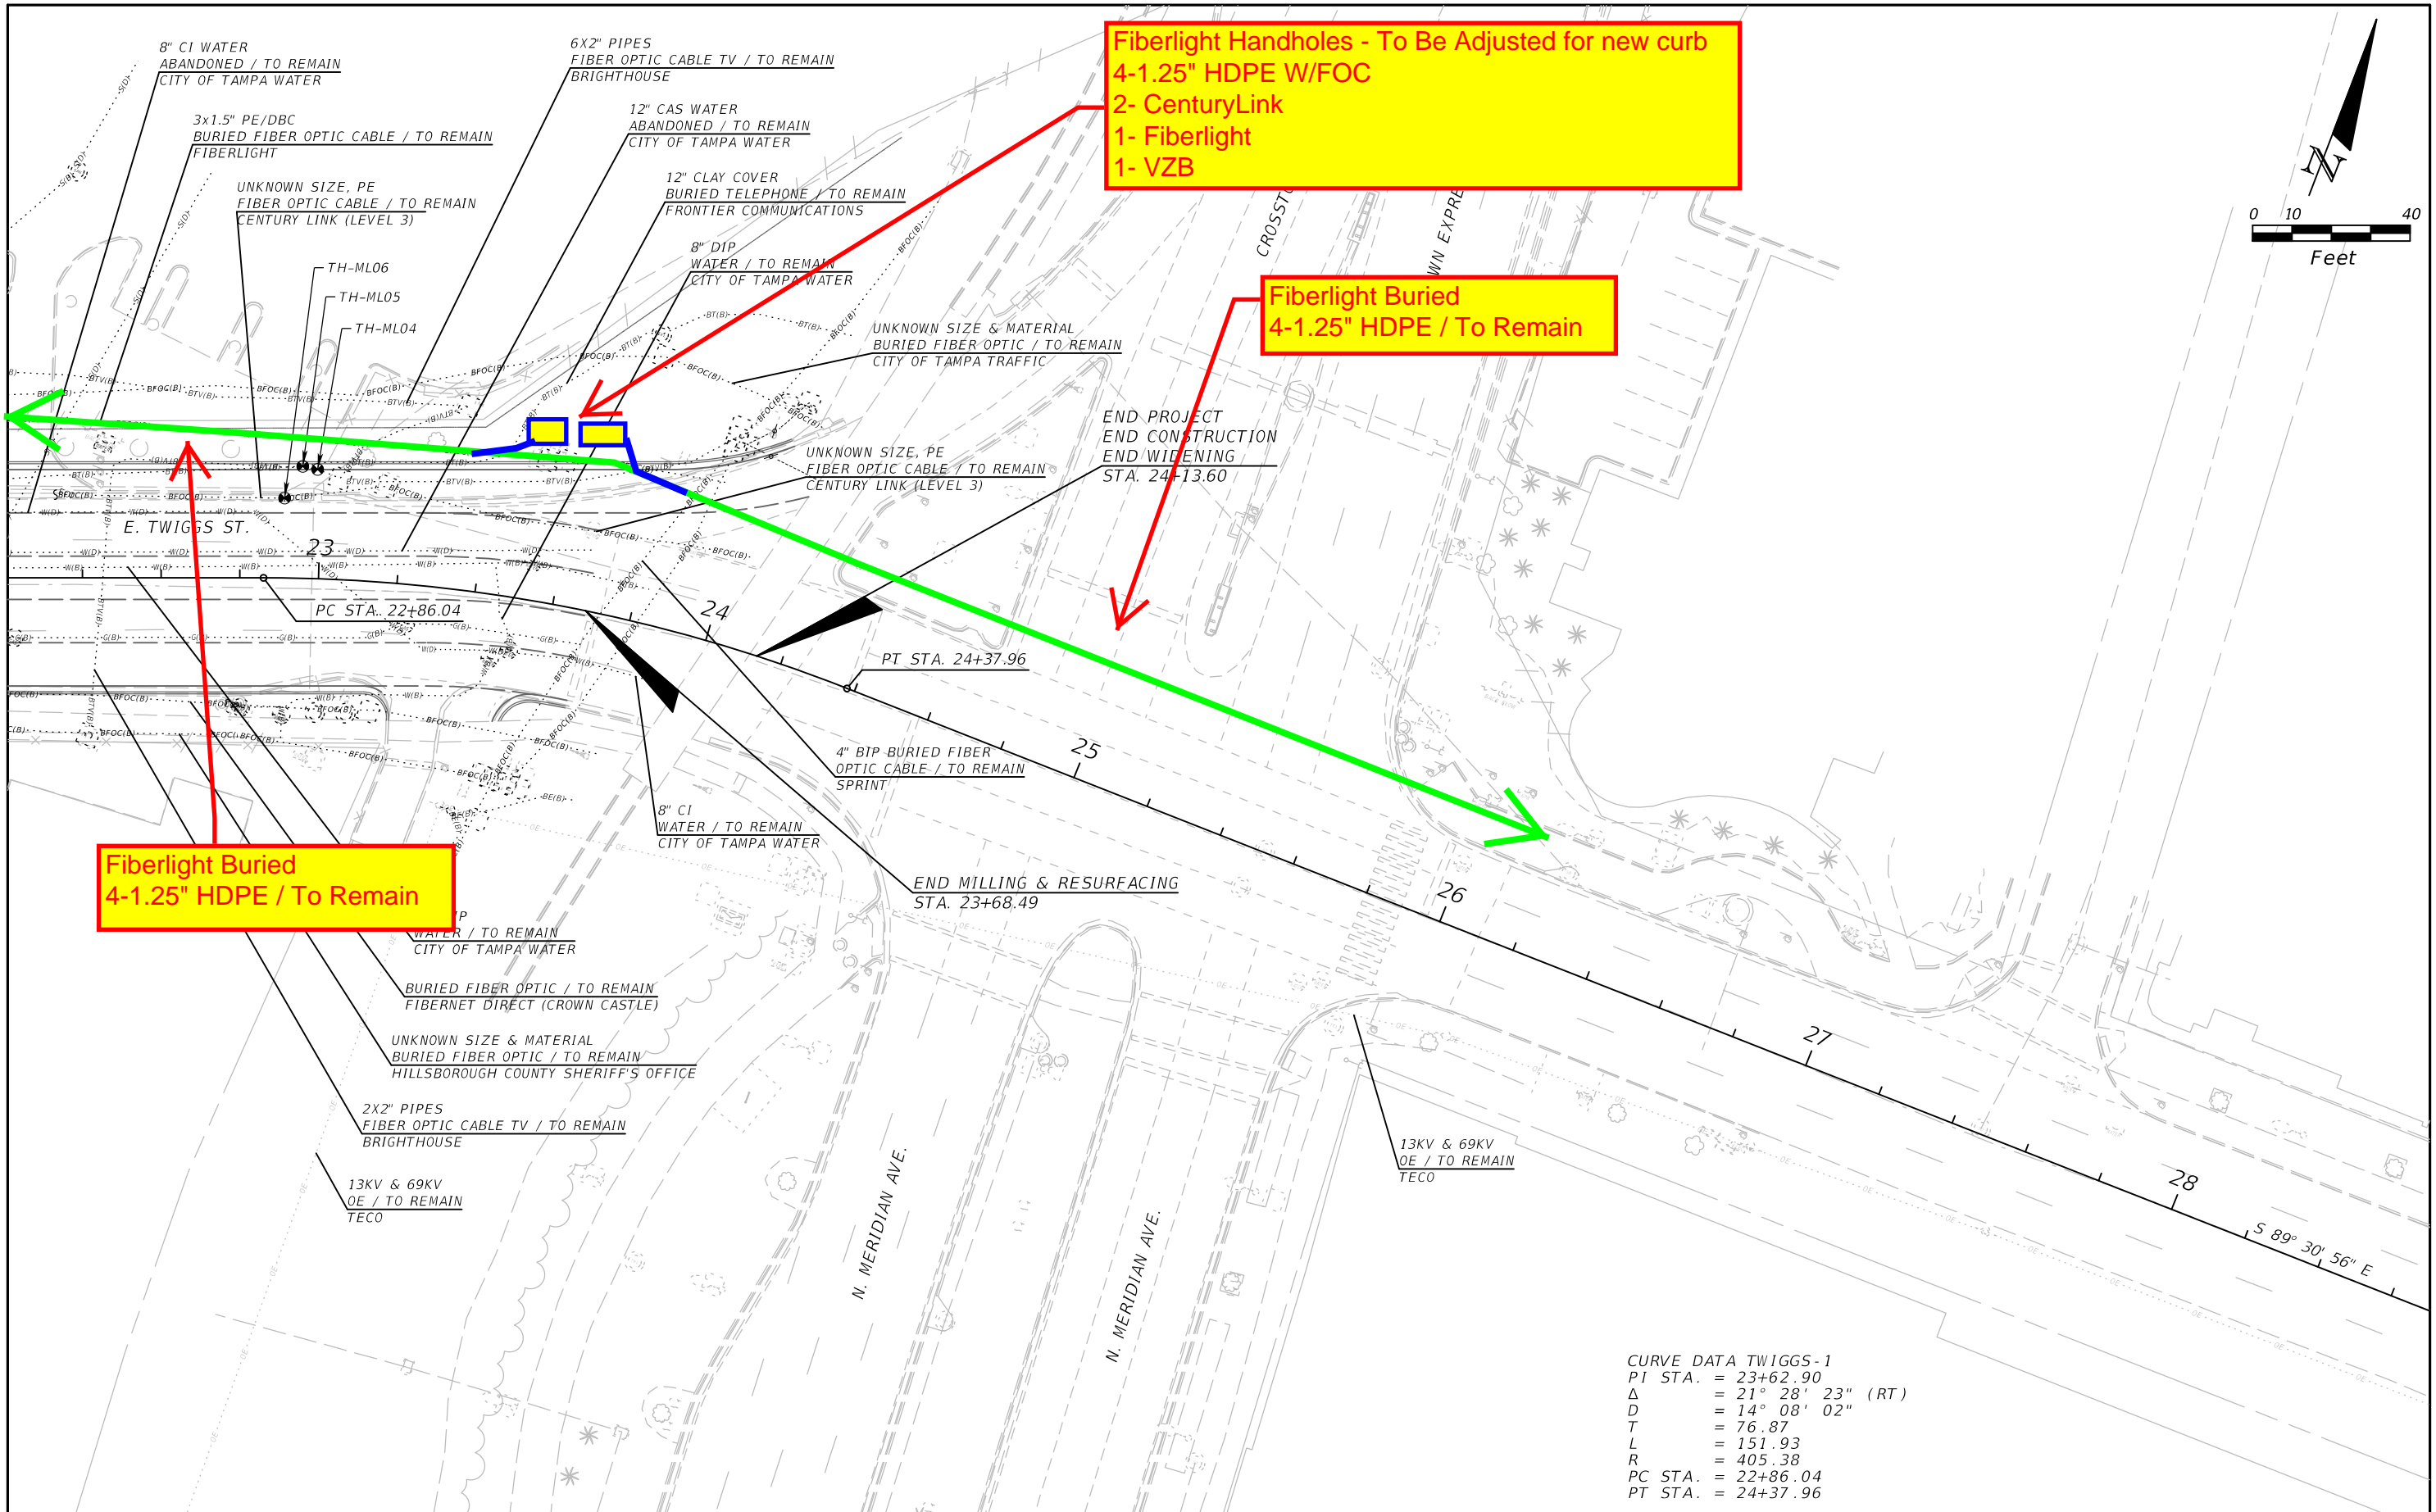

REVISIONS				MEGAN M. TETRO, P.E. FLORIDA PE NO. 76120 WANTMAN GROUP, INC. 3111 W. MARTIN LUTHER KING JR. BLVD., SUITE 375, TAMPA, FL 33607 CERTIFICATE OF AUTHORIZATION NO. 6091	TAMPA HILLSBOROUGH EXPRESSWAY AUTHORITY			UTILITY ADJUSTMENT (2)	SHEET NO. 5
DATE	DESCRIPTION	DATE	DESCRIPTION		ROAD	COUNTY	CONTRACT NO.		
					TWIGGS	HILLSBOROUGH	000419		

THE OFFICIAL RECORD OF THIS SHEET IS THE ELECTRONIC FILE DIGITALLY SIGNED AND SEALED UNDER RULE 61G15-23.004, F.A.C.

FLORIDA DEPARTMENT OF TRANSPORTATION
UTILITY WORK SCHEDULE

December 14, 2016

Pursuant to Section 337.403 F.S., the UAO and FDOT agree to the UAO's need for relocation or adjustment to its utilities and FDOT's need for a schedule for the UAO to effect the relocation or adjustment. This utility work schedule is based on FDOT plans dated in the project information box below. Any deviation by FDOT or its contractor from these plans, may void this utility work schedule. Upon notification by FDOT of a change to these plans, the UAO may negotiate a new utility work schedule. The UAO agrees to notify FDOT and the contractor in writing prior to starting, stopping, resuming, and completing work in accordance with this utility work schedule. The UAO shall obtain a utility permit and comply with requirements of the 2017 Utility Accommodation Manual (UAM) for all work done under this utility work schedule. The UAO is not responsible for events beyond the control of the UAO that could not be reasonably anticipated by the UAO and which could not be avoided by the UAO with exercise of due diligence at the time of the occurrence.

FDOT PROJECT INFORMATION

Financial Project ID: O-00419	Federal Project ID:
State Road Number: N/A	County: Hillsborough
FDOT Plans Dated: July 2019	District Document No.: N/A

UTILITY AGENCY/OWNER (UAO)

Utility Company: Fiberlight, LLC		
UAO Project Rep: Tim Green	Phone: 813-877-7183	E-mail: tim.green@fiberlight.com
UAO Field Rep: Neil Cleveland	Phone: 813-877-7185	E-mail: neil.cleveland@fiberlight.com

UTILITY SIGNATURE

I have reviewed the FDOT plans referenced above and submit this utility work schedule in compliance with UAM Section 5 and agree to be bound by the terms of this utility work schedule.

UAO Rep. tim.green@fiberlight.com
Name Tim Green
Title Director of Construction

Digitally signed by tim.green@fiberlight.com
DN: cn=tim.green@fiberlight.com
Date: 2019.11.14 13:19:18 -05'00'

Date 11 / 14 / 2019

ENGINEER OF RECORD SIGNATURE

I attest this utility work schedule is compatible with the FDOT plans referenced above.

EOR. Megan Tetro
Name Megan Tetro, P.E.
Title Engineer of Record

Date 11/14/19

APPROVAL BY DISTRICT UTILITIES

This utility work schedule is complete and acceptable to FDOT.

FDOT Rep. David May
Name David May
Title Director of Operations

Date 03/10/2020

SECTION A: SUMMARY OF UTILITY WORK

The below days are the total numbers of days shown for all activities in Section C of this utility work schedule. The breakdown of how these days are to be incorporated into the FDOT project and the dependence of these days upon the completion of other activities by the UAO or others is shown in Section C.

Days prior to FDOT project construction: 0

Days during FDOT project construction: 5

FLORIDA DEPARTMENT OF TRANSPORTATION
UTILITY WORK SCHEDULE

December 14, 2016

Financial Project ID: O-00419
Utility Company: Fiberlight, LLC
FDOT Plans Dated: July 2019

SECTION B: UAO SPECIAL CONDITIONS/CONSTRAINTS

1. Fiberlight field contact must be notified 72 hours prior to excavating when within 3' of the existing Fiberlight fiber optic duct system.
2. In the event of an emergency, please call the Fiberlight NOC 24x7 at 800-672-0181

FDOT Plans Dated: July 2019

SECTION C: UAO's WORK ACTIVITIES

[illegible]